


As Built

S1084.0  
MP280DH

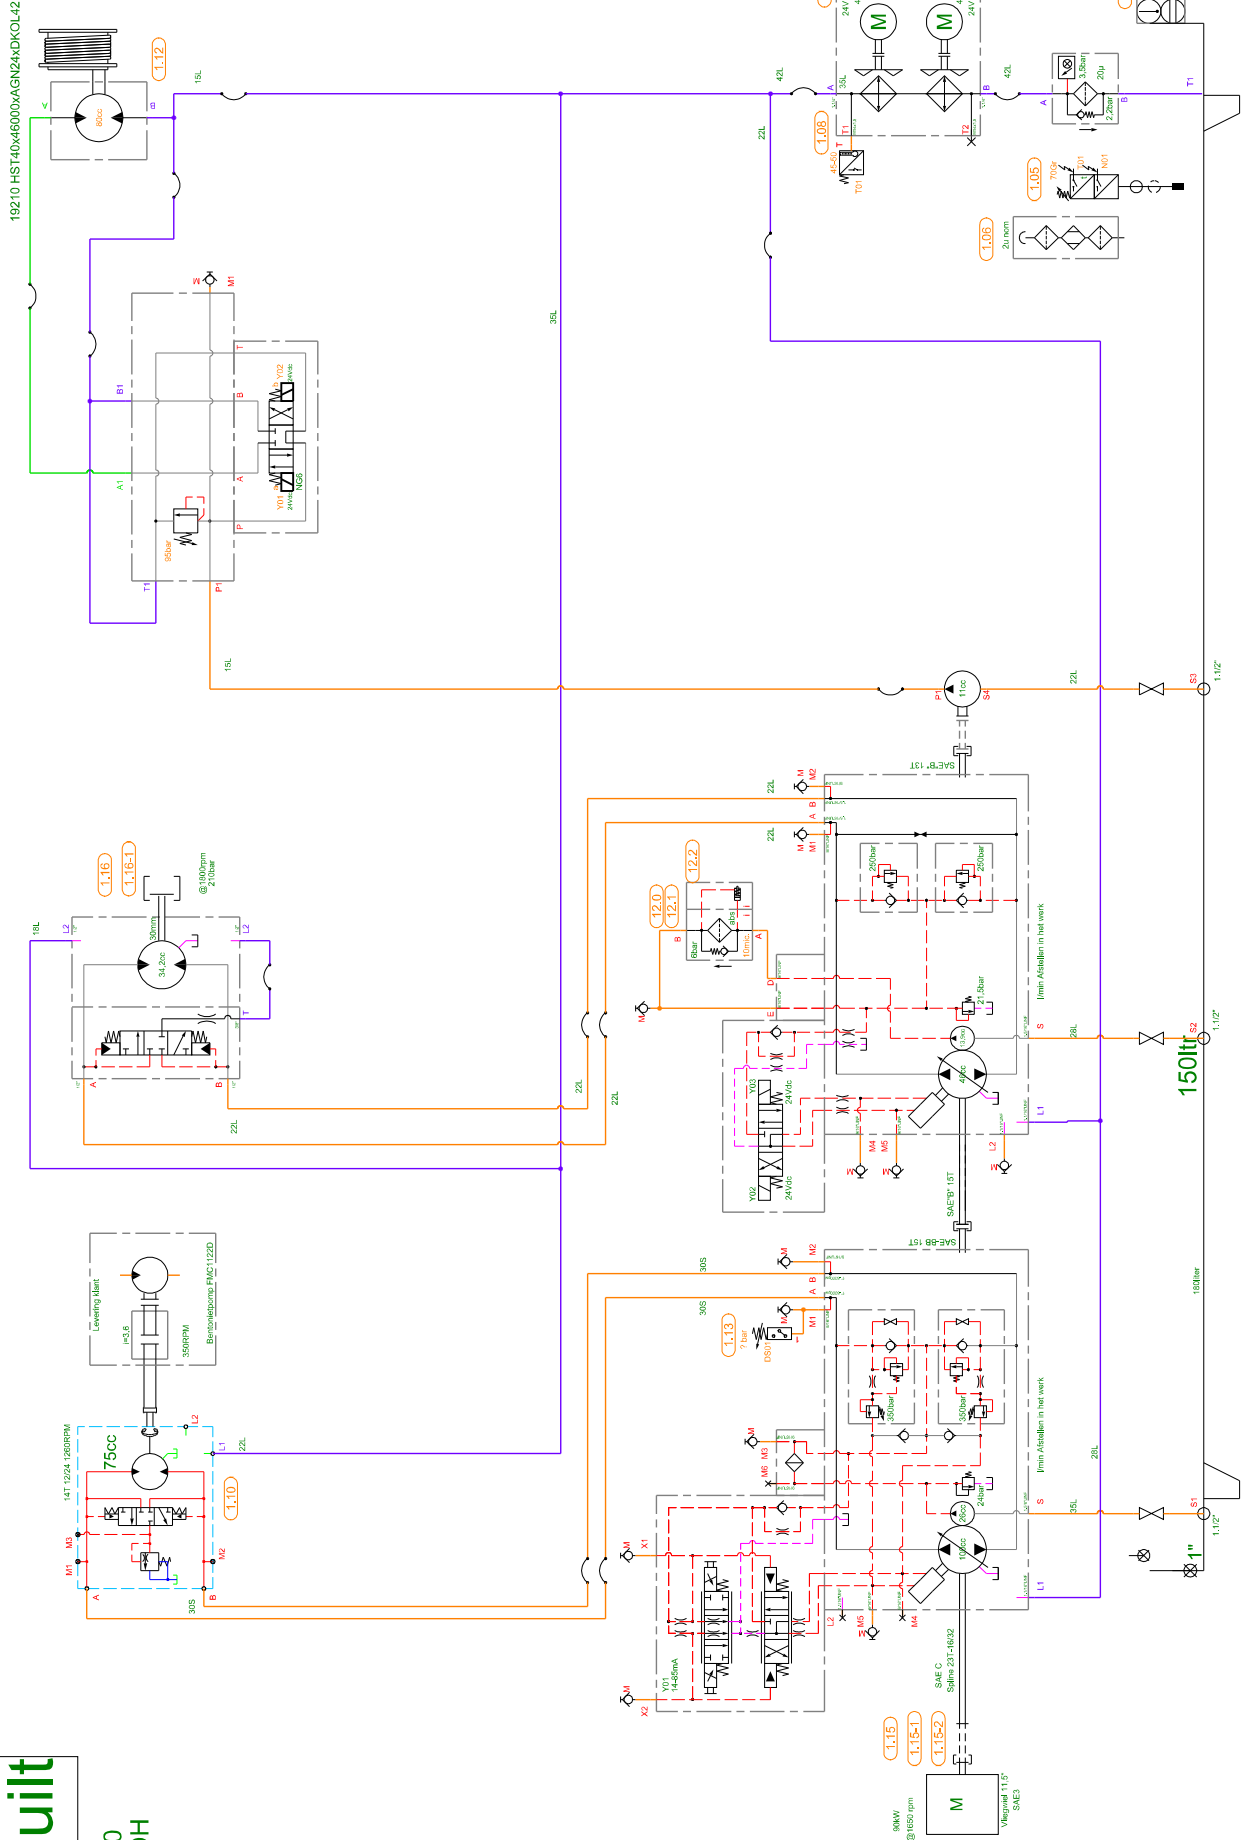

**SWANENBERG**  
hydraulic systems

Achterdijk 9, 5705 CB HELMOND, T: +31 (0)492-552922 WWW.SWANENBERG.NL

Revision Nr. Date

Designer: AU	Drawing Nr. S1084.0
Date: 12-2022	Page Nr. 1
Status: As Built	Pages 1
Customer: Sitetec	
Project: MP280DH	